



**AS-BUILT FLOOR PLAN  
CONDO SAMPLE**

250 Beacon Street  
Boston, MA 02116

Unit Floor Plan  
Ceiling Height = 8'-7"

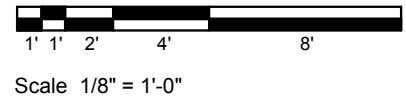

1

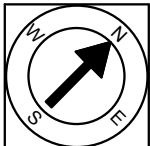

Note: Dimensions are not guaranteed and are provided for informational purposes only.

NEW ENGLAND  
FLOOR PLANS  
& PHOTOGRAPHY  
(800) 328-0217